


MAR-11-03 06:45 PM COOKE EXCAVATING

466 2188

P. 61

AS BUILT

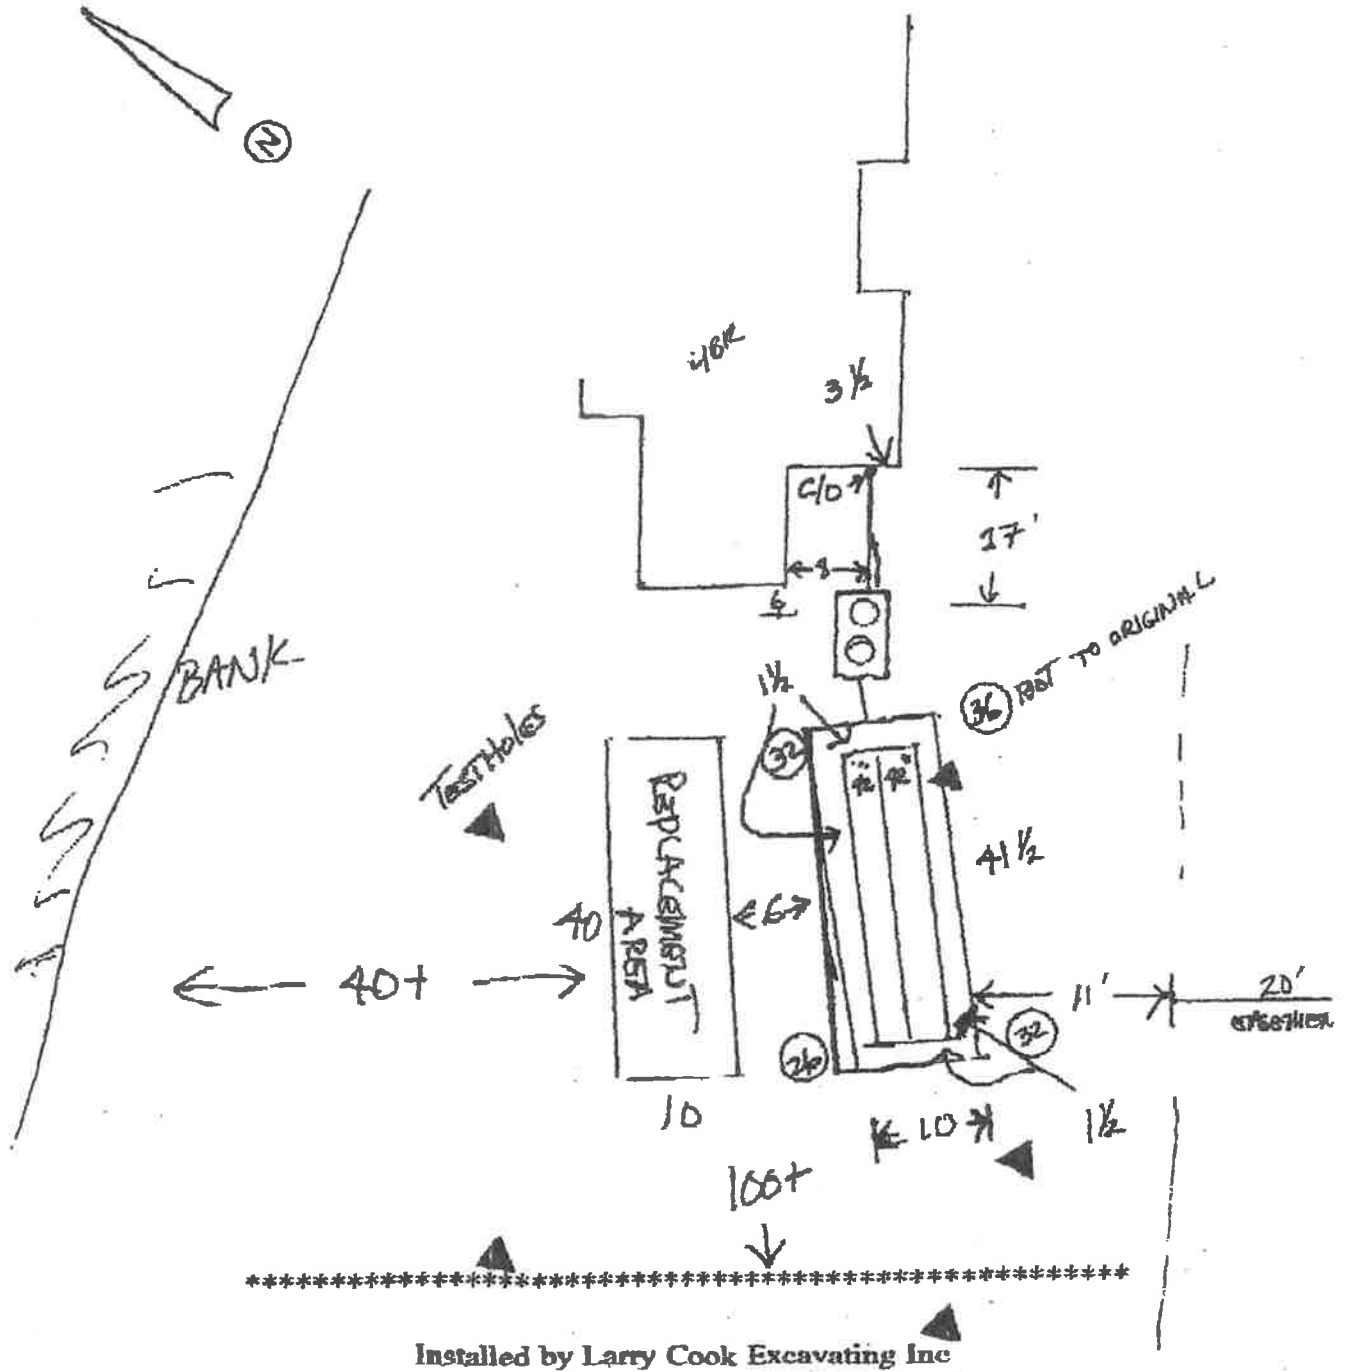

HANNA / 02-4270 / 14418 W CHARLES RD / 3-11-03

5/3/2013

Exhibit "C"